

RECORD DRAWINGS

for

LAKEWOOD ORCHARD

ROUND LAKE, ILLINOIS

PROJECT NO:3059.09

DEVELOPER

LAKEWOOD HOMES
2700 W. HIGGINS ROAD, SUITE 100,
HOFFMAN ESTATES, IL. 60195
(847) 884-8800, FAX (847) 884-8986

CALL J.U.L.I.E. 1-800-892-0123

WITH THE FOLLOWING:

COUNTY LAKE

CITY, TOWNSHIP ROUND LAKE, FREMONT

SEC. & 1/4 SEC. NO. T44N, R10E, SEC 5

48 HOURS BEFORE YOU DIG.
EXCLUDING SAT., SUN. & HOLIDAYS

INDEX

SHEET #	SHEET I.D.	SHEET DESCRIPTION
1	C1	TITLE SHEET
2	TS1	TYPICAL SECTIONS & GENERAL NOTES
3	OV1	OVERALL ROADWAY AND UTILITY PLAN
4-7	E1-E4	EXISTING CONDITIONS PLANS
8-11	L1-L4	GEOMETRIC & LIGHTING PLANS
12-16	G1-G5	GRADING PLANS
17-20	U1-U4	UTILITY PLANS
21	PP1	PLAN AND PROFILE - MEADOW LANE STA. 10+00 TO STA. 20+00
22	PP2	PLAN AND PROFILE - MEADOW LANE STA. 20+00 TO STA. 27+00
23	PP3	PLAN AND PROFILE - TESS LANE
24	PP4	PLAN AND PROFILE - DALTON DRIVE STA. 11+60 TO STA. 25+00
25	PP5	PLAN AND PROFILE - DALTON DRIVE STA. 25+00 TO STA. 31+60 & DALTON COURT
26	PP6	PLAN AND PROFILE - EAGON LANE & MARA LYNN COURT
27	EC1	STORM WATER POLLUTION PREVENTION PLAN
28	EC2	SOIL EROSION CONTROL PLAN
29-30	WM1-WM2	WETLAND MITIGATION PLANS
31	SI1	SIGNAGE PLAN
32	S1	SPECIFICATIONS
33-38	D1-D6	DETAILS

BENCHMARK

ELEVATION:

DESCRIPTION: SEE SHEET TS1 OF THE FINAL ENGINEERING
PLANS FOR BENCHMARK INFORMATION

NOTE:

SPACECO, INC. IS TO BE NOTIFIED AT LEAST
THREE (3) DAYS PRIOR TO STARTING CONSTRUCTION
AND SHALL BE INCLUDED IN THE PRECONSTRUCTION MEETINGS

RECORD DRAWING

JANUARY
DATE: 2005


SHEET 1 OF 11

ENGINEER
STEPHEN J. CROSS, P.E.
ILLINOIS REGISTRATION NO.: 062-049984
EXPIRATION DATE: 11/30/2005


PROFESSIONAL DESIGN FIRM NO.: 184-001157
EXPIRATION DATE: 04/30/2005

THESE PLANS OR ANY PART THEREOF SHALL BE CONSIDERED VOID WITHOUT
THE SIGNATURE, SEAL, AND EXPIRATION DATE OF SEAL OF THE ENGINEER

LOCATION MAP

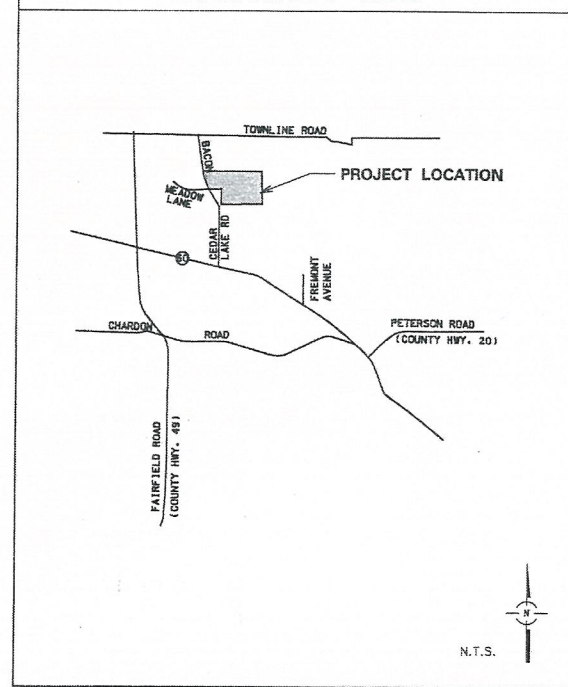

KEY MAP

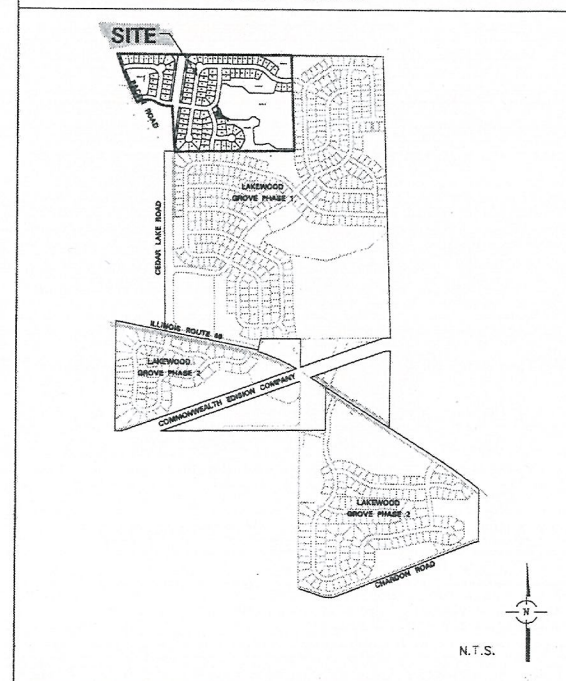

REVISIONS

#	SHEET #	REMARKS	DATE
1	3,8,12,17,21,23	PER OWNER	5/28/04
2	ALL SHEETS	PER OWNER/SPACECO	6/9/04
3	G1, U1	REV CEDAR LK ROW GRADES	6/30/04
4	1,3,12,13,17,18, 24,26,37	PER LCSMC	7/6/04
5	ALL SHEETS	PER VILLAGE	7/12/04
6	ALL SHEETS	PER SCOPW, RLSD, NWSWRF	7/26/04
7	17,20-26,32	PER ROUND LAKE SANITARY DIST. & SPACECO	8/11/04
8	3,8,9,11-15,17-22,24,29,36	PER OWNER/SPACECO	8/31/04
9	3,12,17-19,23, 28,30,37,38	PER OWNER/SPACECO	9/22/04
10	17,18	B-BOX LOCATIONS REVISED	9/29/04
11	2,34	PER OWNER	10/5/04
12	34	DROP/MANHOLE DETAIL	10/18/04

LAKEWOOD ORCHARD
ROUND LAKE, IL

9575 W. Higgins Road, Suite 700, Rosemont, Illinois 60018
Phone: (847) 696-4060 Fax: (847) 696-4065

CONSULTING ENGINEERS
SITE DEVELOPMENT ENGINEERS
LAND SURVEYORS



FILENAME:
3009TITLE.DGN

DATE:
03/16/04

JOB NO.
3059.09

SHEET
C1

1 OF 38